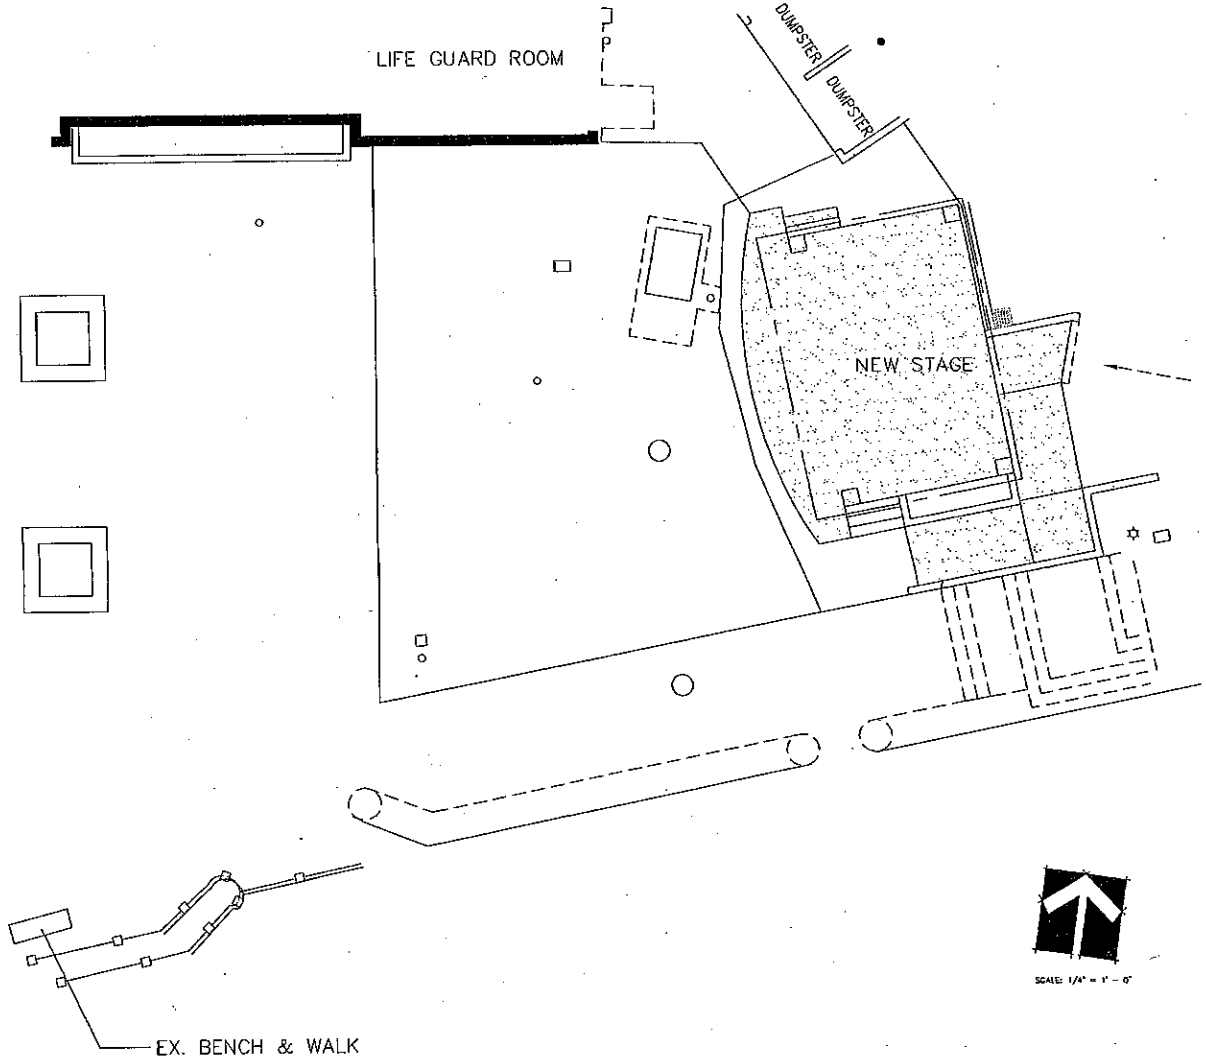

AS BUILT

DATE ALERT TO
PROJECT ENG.
REVISIONS BY
DATE

CITY OF CAPITOLA

DEPARTMENT OF PUBLIC WORKS

NO	BY	DATE	REVISION	CHK'D

ANY BORDER PROJECTION

PROJECT

DESIGNED JA
DRAWN
CHECKED EM
MASTER
SCALE

DATE

SHEET

OF